

ORDINANCE NO. 10212015A

GRANTING MAYOR ABILITY TO APPROVE FACILITIES TRANSFER AGREEMENT BETWEEN BURR OAK REGIONAL WATER DISTRICT AND VILLAGE OF JACKSONVILLE, OHIO

WHEREAS, the Village of Jacksonville desires to facilitate the completion of the Village's Radio/Telemetry System Project by providing an existing vault for the proposed equipment and provide high and low pressure connection for future water system improvements;

WHEREAS, the Burr Oak Regional Water District (BORWD) currently owns and is willing to transfer ownership of the waterline and appurtenances extending from the Trimble meter vault approximately 1700 feet adjacent to State Rt. 13;

WHEREAS, the BORWD also desires to install a replacement meter vault upon an easement located in the Village of Trimble at the abandoned Trimble School property;

WHEREAS, the construction will need to begin in the very near future in order to meet the project's deadlines;

NOW, THEREFORE, BE IT ORDAINED BY THE VILLAGE COUNCIL OF THE JACKSONVILLE, ATHENS COUNTY, OHIO AS FOLLOWS:

1. The Village of Jacksonville shall assume ownership of the existing 8" Asbestos Cement Waterline/Valves, the existing meter vault and interior appurtenances (pressure regulators, valves, interior piping).
2. The BOWRD shall install a replacement meter upon an easement located in the Village of Trimble at the abandoned Trimble School property.

Handwritten signatures and names at the bottom of the page, including "D.A. Molinski" and other illegible signatures.

3. The Mayor's office is authorized to sign any and all documents necessary to complete the aforementioned projects.


4. It is found and determined that all formal actions of Council concerning and relating to the passage of this Ordinance were conducted in open meetings of Council, and that all deliberations of Council that resulted in formal action were in meetings open to the public, in compliance with all legal requirements including Sec. 121.22 of the Ohio Revised Code.

5. This Ordinance is being passed as an emergency measure under suspension of the rules, to take effect immediately, pursuant to Ohio Rev. Code Sec. 731.30 because it is necessary for the immediate preservation of the health, safety and welfare of the Citizens of Jacksonville.


6. Publication of this Ordinance shall be made by posting a copy of the same in at least 5 locations within the Village.

7. This Ordinance shall become effective the earliest date allowed by law.


VILLAGE OF JACKSONVILLE:


By: 
Mayor

President Pro Tem of Council

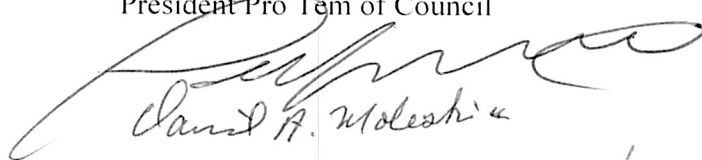
David A. Maleski

ATTEST/SEAL:


Amber Mayle
10/23/15

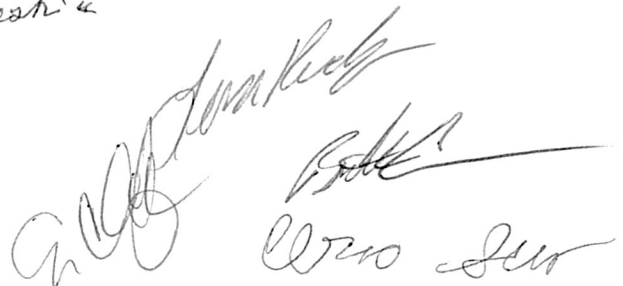

Clerk - Treasurer/Fiscal Officer

CERTIFICATION OF CLERK/FISCAL OFFICER

The foregoing is a true copy of the original Ordinance # 10212015A

Publication of this Ordinance was made by posting a copy of the same in the following five (5) locations within the Village, beginning on 10/23/15, 2015, and concluding on 11/9/15, 2015 (at least 15 days later):

- Post Office
- Eagles Club
- VFW
- Town Hall
- Jerry's Bar

ATTEST:

DATE: 10/23/15

Amber Mayle
Village Fiscal Officer/Clerk

CERTIFICATION

I, Amber Mayle, Clerk for the Village of Jacksonville, Athens County, Ohio, certify that the foregoing is a true and correct copy of a Ordinance adopted by the Village Council of the Village of Jacksonville, and appears in the Village records as Ordinance No. 10232015A.

ATTEST:

10/23/15

DATE



Village Fiscal Officer

FACILITIES TRANSFER AGREEMENT

FROM


BURR OAK REGIONAL WATER DISTRICT (BORWD)


TO


VILLAGE OF JACKSONVILLE, OHIO


RESOLUTION # 10232015A The Village of Jacksonville agrees to accept ownership of an existing **8" Asbestos Cement Waterline/ Valves, in addition to the existing meter vault and interior appurtenances, (to include pressure regulator, valves and interior piping).** The purpose of this transfer is to facilitate the completion of the Villages Radio /Telemetry System Project by providing an existing vault for the proposed equipment, as well as providing a high and low pressure connection point for future water system improvements.

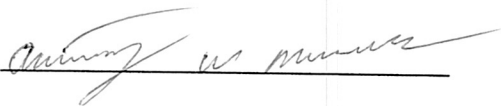


The Village will be responsible for all maintenance, repairs, or replacement, for all referenced transfer appurtenances, to include the approximate 1700 feet portion of asbestos cement waterline located adjacent to the West side of State Route 13, going South to the existing Jacksonville meter vault, which is included in the transfer agreement. A replacement meter vault will be installed by BORWD upon an easement located in the Village of Trimble (abandoned Trimble School property). Village of Jacksonville will assume ownership of all waterline and appurtenances extending from the Trimble meter vault South to the existing meter vault as shown on attached **EXHIBIT A.**

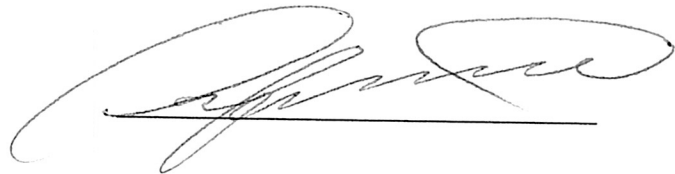


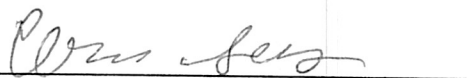

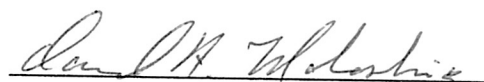




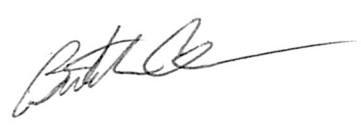

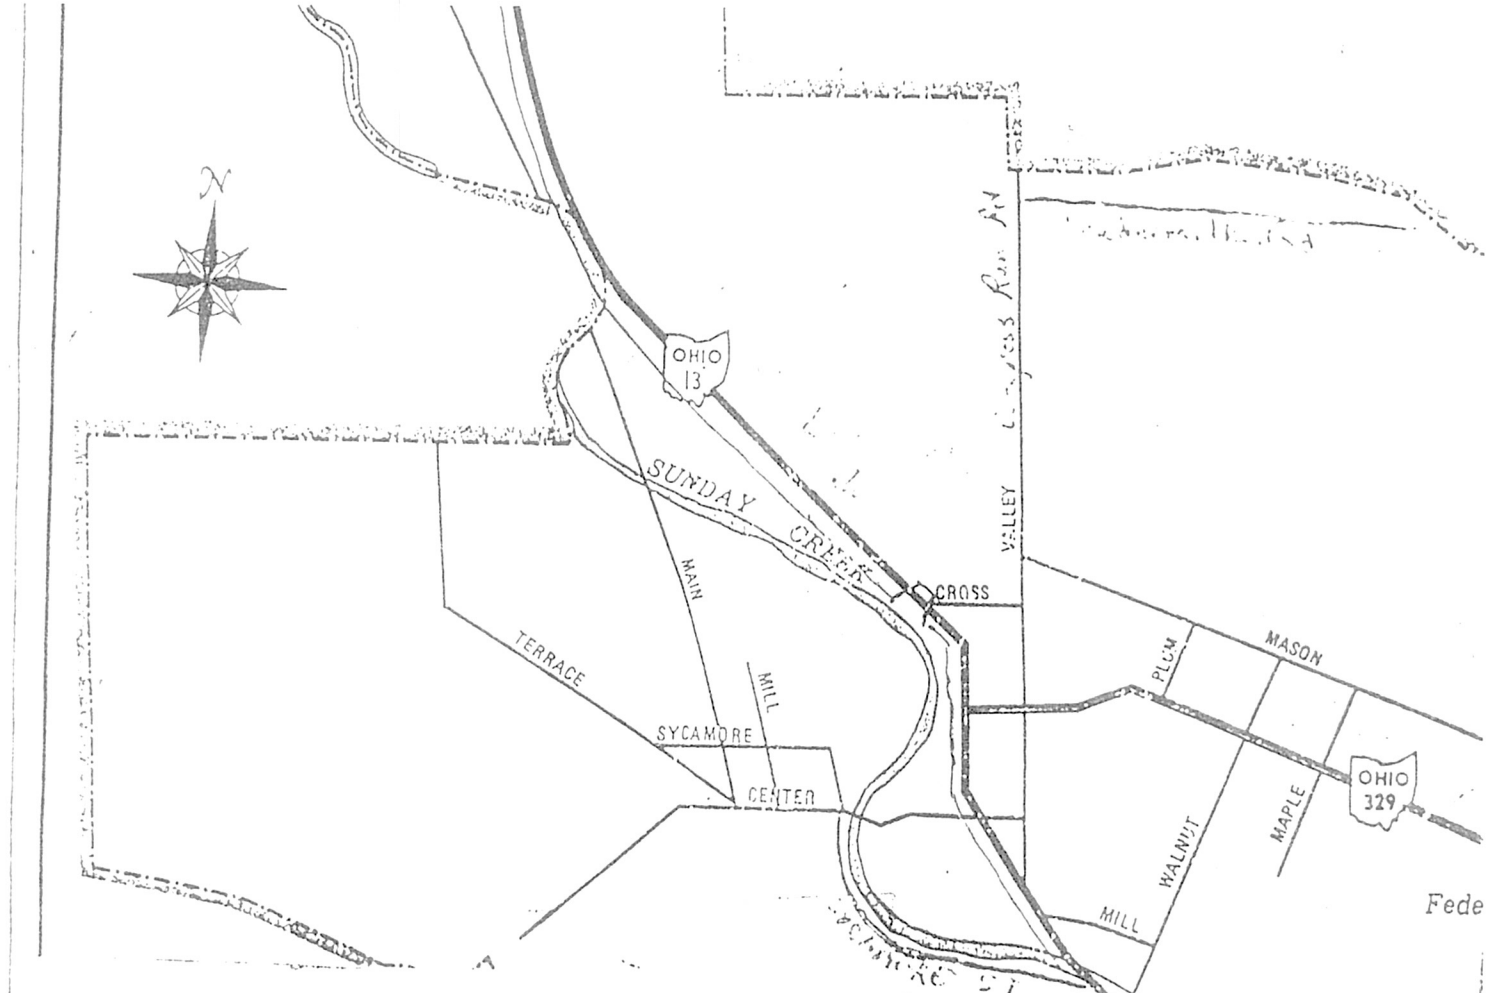JACKSONVILLE

*BORWD
Proposed
NEW METER VAULT*

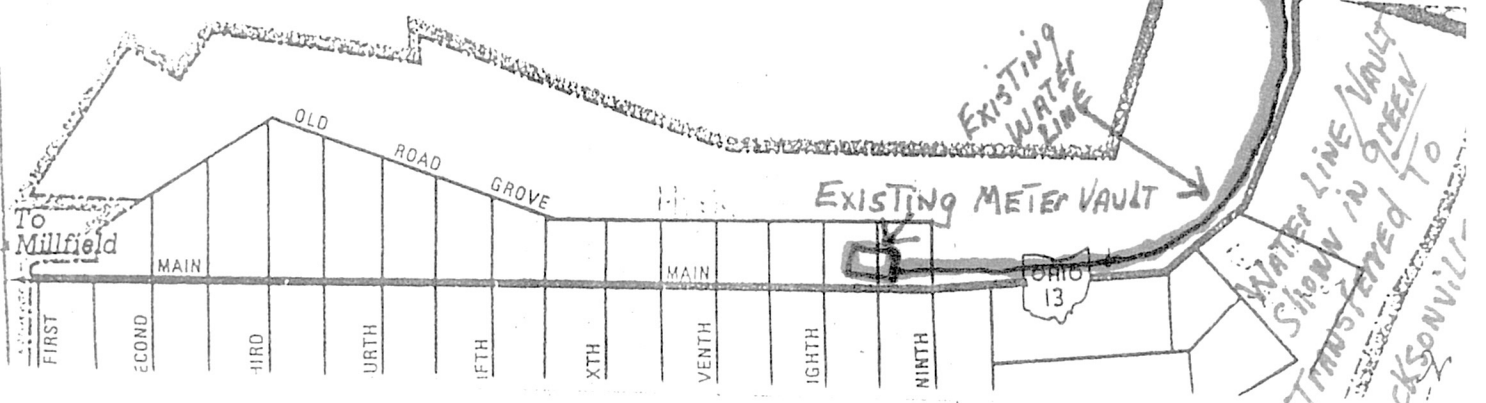

*Water Line/Vault
Shown in Green
Transferred to
Jacksonville*